


DIM. TO CL OF DEMISING WALL W/ ADJACENT TENANT

"EXCEPT AS EXPRESSLY PROVIDED IN A LEASE AGREEMENT, THIS PLAN, DRAWING, OR EXHIBIT IS FOR INFORMATION PURPOSES ONLY AND INTENDED ONLY AS A GENERAL DESCRIPTION OF IMPROVEMENTS WHICH CONSTITUTE A PART OF THE RETAIL COMPLEX OF THE DEVELOPMENT. SPECIFIC NAMES, LOCATIONS, DIMENSIONS OF ANY STORES, ENTRANCES OR IMPROVEMENTS ARE SUBJECT TO CHANGE, MODIFICATION, ALTERATION AND DELETION BY LANDLORD OR OTHER PARTIES, AND ARE NOT A REPRESENTATION OR WARRANTY AS TO THE OPENING OR CONTINUED OPERATION OF ANY STORE NAMED OR DEPICTED ON ANY PLAN, DRAWING OR EXHIBITS. LANDLORD RESERVES THE RIGHT TO CHANGE THE NUMBER AND LOCATION OF BUILDINGS, BUILDING DIMENSIONS, THE NUMBER OF FLOORS IN ANY OF THE BUILDINGS, STORE DIMENSIONS AND LOCATION, AND THE IDENTITY AND TYPE OF OTHER TENANCIES AND OCCUPANCIES."

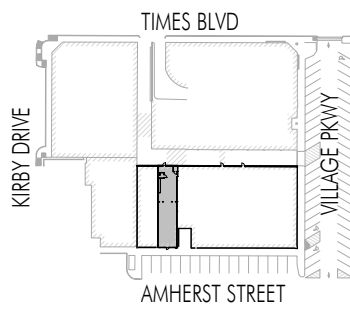

RICE VILLAGE BUILDING E E150

AS-BUILT LEASE OUTLINE DRAWING

SCALE: 1/8" = 1' - 0"



RETAILER: AVAILABLE
BUILDING : E
PERIMETER: 214' - 8 1/4"
STOREFRONT: 20' - 0"
LOD: 1,712 SF
ISSUED: 07/16/2019
UPDATED:
PROJECT NO: 1905700